



---

RE: WATER SYSTEM IMPROVEMENTS PROJECT NO. E08-237  
CITY OF LAWRENCEVILLE, GEORGIA  
CONTRACT 2 - LAWRENCEVILLE WATER TREATMENT AND WATER DEPARTMENT FACILITIES

FROM: PRECISION PLANNING, INC. TO: PROSPECTIVE BIDDERS  
(770) 338-8000

---

THIS ADDENDUM FORMS A PART OF THE CONTRACT DOCUMENTS AND CONSTRUCTION DRAWINGS AND MODIFIES THE ORIGINAL BIDDING DOCUMENTS FOR THE REFERENCED PROJECT DATED FEBRUARY 2010.

---

The following items of the contract documents are modified as part of this addendum:

(1) **Partial Utilization - Functional Operation for Potable Water Production:**

- a. Section 00510, Article 3. Revise the first paragraph to redefine partial utilization of the project as follows:

*That the CONTRACTOR shall commence the work to be performed under this Agreement on a date to be specified in a written Notice to Proceed and shall fully complete all work within three hundred sixty five (365) consecutive calendar days and that the CONTRACTOR shall fully complete all work necessary for the OWNER to achieve partial utilization of the project facilities to produce potable water within one hundred eighty (180) consecutive calendar days from the date of the written Notice to Proceed. At a minimum, partial utilization shall include functional operation of the clearwell and high service pumps with water supply from the existing Winer Well #7 using the well's existing power supply, controls and treatment facilities and the new raw water piping from Winer Well #7 as needed. Functional operation shall allow OWNER to produce potable water for use in the OWNER's distribution system as approved by Georgia Environmental Protection Division.*

- b. Section 01025, Article 3.07. Add the following to the list of items forming the basis of payment for Site Development - Water Treatment Facility:

All labor, equipment and materials, as specified and as shown on the Drawings to include relocation of, and modifications to, existing well #7 transmission and treatment facilities and temporary piping connections necessary to meet requirements for partial utilization of clearwell and high service pumps for production of potable water shall be included in the lump sum for this item.

- c. Contractor shall install temporary connection between 8" raw water line and 12" filter effluent line as shown on Attachment 2. Megalugs only shall be provided for thrust restraint for 8" and 12"x8" tees and 8" 90 degree bend on temporary connection and 12" and 8" caps/plugs on permanent lines. Contractor shall clean, disinfect and test the temporary connection piping as specified in 15050 of the Specifications. Only treated water from Winer Well #7 will be allowed to flow through this connection.

Upon demolition of existing Winer Well #7 treatment and electrical control and power facilities, Contractor shall decommission temporary connection between raw water line and cut and plug temporary connection as indicated on Attachment 2.

Cost of this work shall be included in the lump sum price of "Site Development" as stated in Item 1b of this addendum.

- d. Filter building construction shall be adequate to properly protect the power supply and control facilities needed to operate the high service pumps for partial utilization.

(2) **Signage Details:** Sheet A9.1. Revise Finish Plans and Schedules to include the signage details and notes as indicated on Attachment 1.

(3) **Miscellaneous Typographical - Contract Documents:**

- a. Section 00100, Article 2. In the list of documents to be completed after contract award, item listed as "Labor and Material Payment Bond (Section 615) shall be revised to read as follows:

*Payment Bond (Section 620)*


- b. Section 00100, Article 28. The first sentence of the 2nd paragraph shall be revised to read as follows:

*The OWNER shall establish the centerline of all of the sanitary sewer manholes.*


- c. Section 00300, page 10: The first paragraph shall be revised to read as follows:

*BIDDER hereby agrees to commence work under this contract on or before a date to be specified in a written "Notice to Proceed" from the OWNER and to fully complete WORK within a total construction time of THREE HUNDRED SIXTY FIVE (365) consecutive calendar days of the date specified in this "Notice to Proceed".*


***END OF ADDENDUM NO. 2***

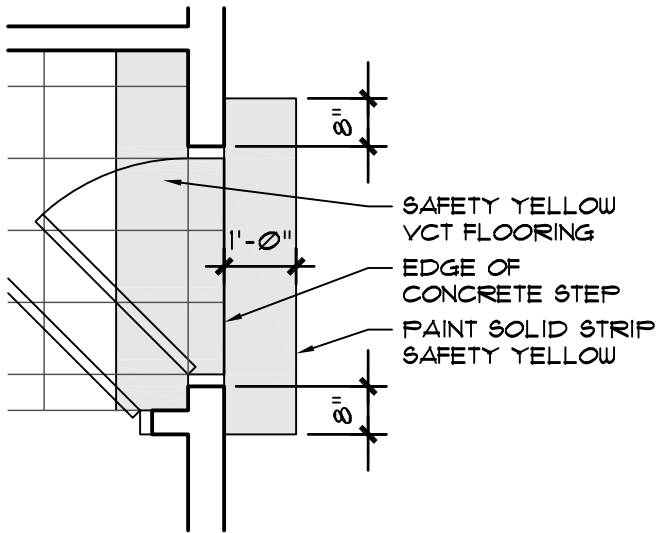

DOOR #106

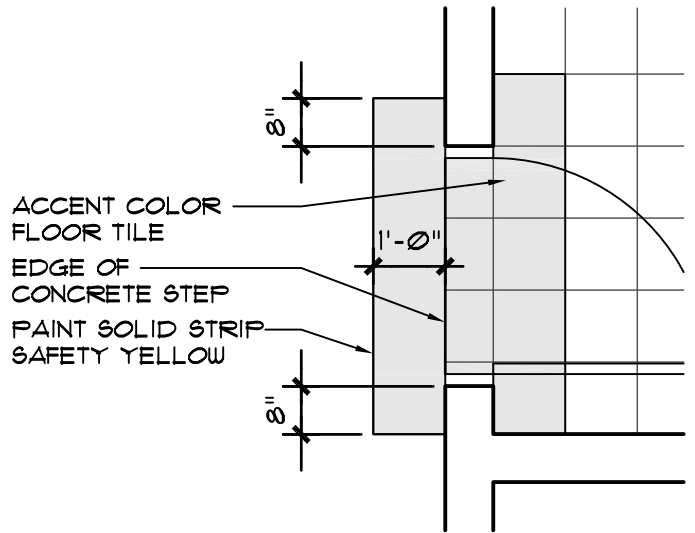


DOOR #117A

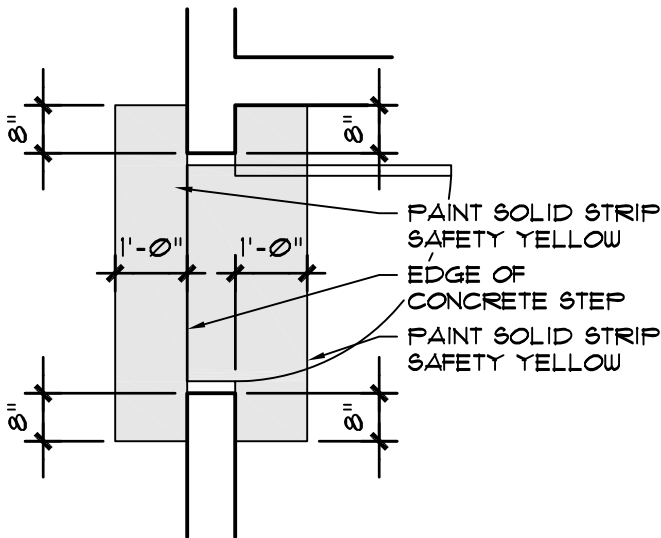

DOOR #121A

PROVIDE WARNING  
SIGNAGE ON BOTH  
SIDES OF DOORS  
#106, #117A AND 121A

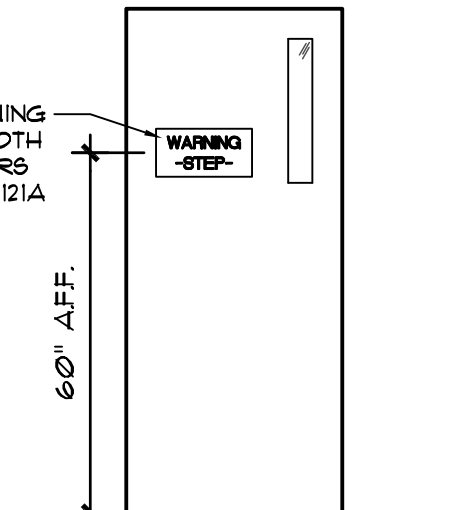

DOOR SIGNAGE

**WARNING SIGNAGE NOTES:**

1. CHARACTERS SHALL BE 2" MINIMUM IN HEIGHT.
2. THE CHARACTERS AND BACKGROUND OF SIGNS SHALL BE EGGSHELL, MATTE, OR OTHER NON-GLARE FINISH.
3. CHARACTERS AND SYMBOLS SHALL CONTRAST WITH THEIR BACKGROUND - EITHER LIGHT CHARACTERS ON DARK BACKGROUND OR DARK CHARACTERS ON LIGHT BACKGROUND.
4. MOUNT SIGNAGE AT 60" A.F.F. TO THE CENTERLINE OF THE SIGN

DATE: 03-05-10

JOB NUMBER : E08237

ADDENDUM # 2  
ATTACHMENT #1


**CITY OF LAWRENCEVILLE  
WATER SYSTEM IMPROVEMENTS  
CONTRACT 2  
WATER TREATMENT AND  
WATER DEPARTMENT FACILITIES**



**Precision Planning, Inc.**

planners, engineers, architects & surveyors  
P.O. Box 2210  
400 Pike Boulevard  
Lawrenceville, GA 30246-2210

PHONE: (770) 338-8000  
FAX: (770) 822-5990

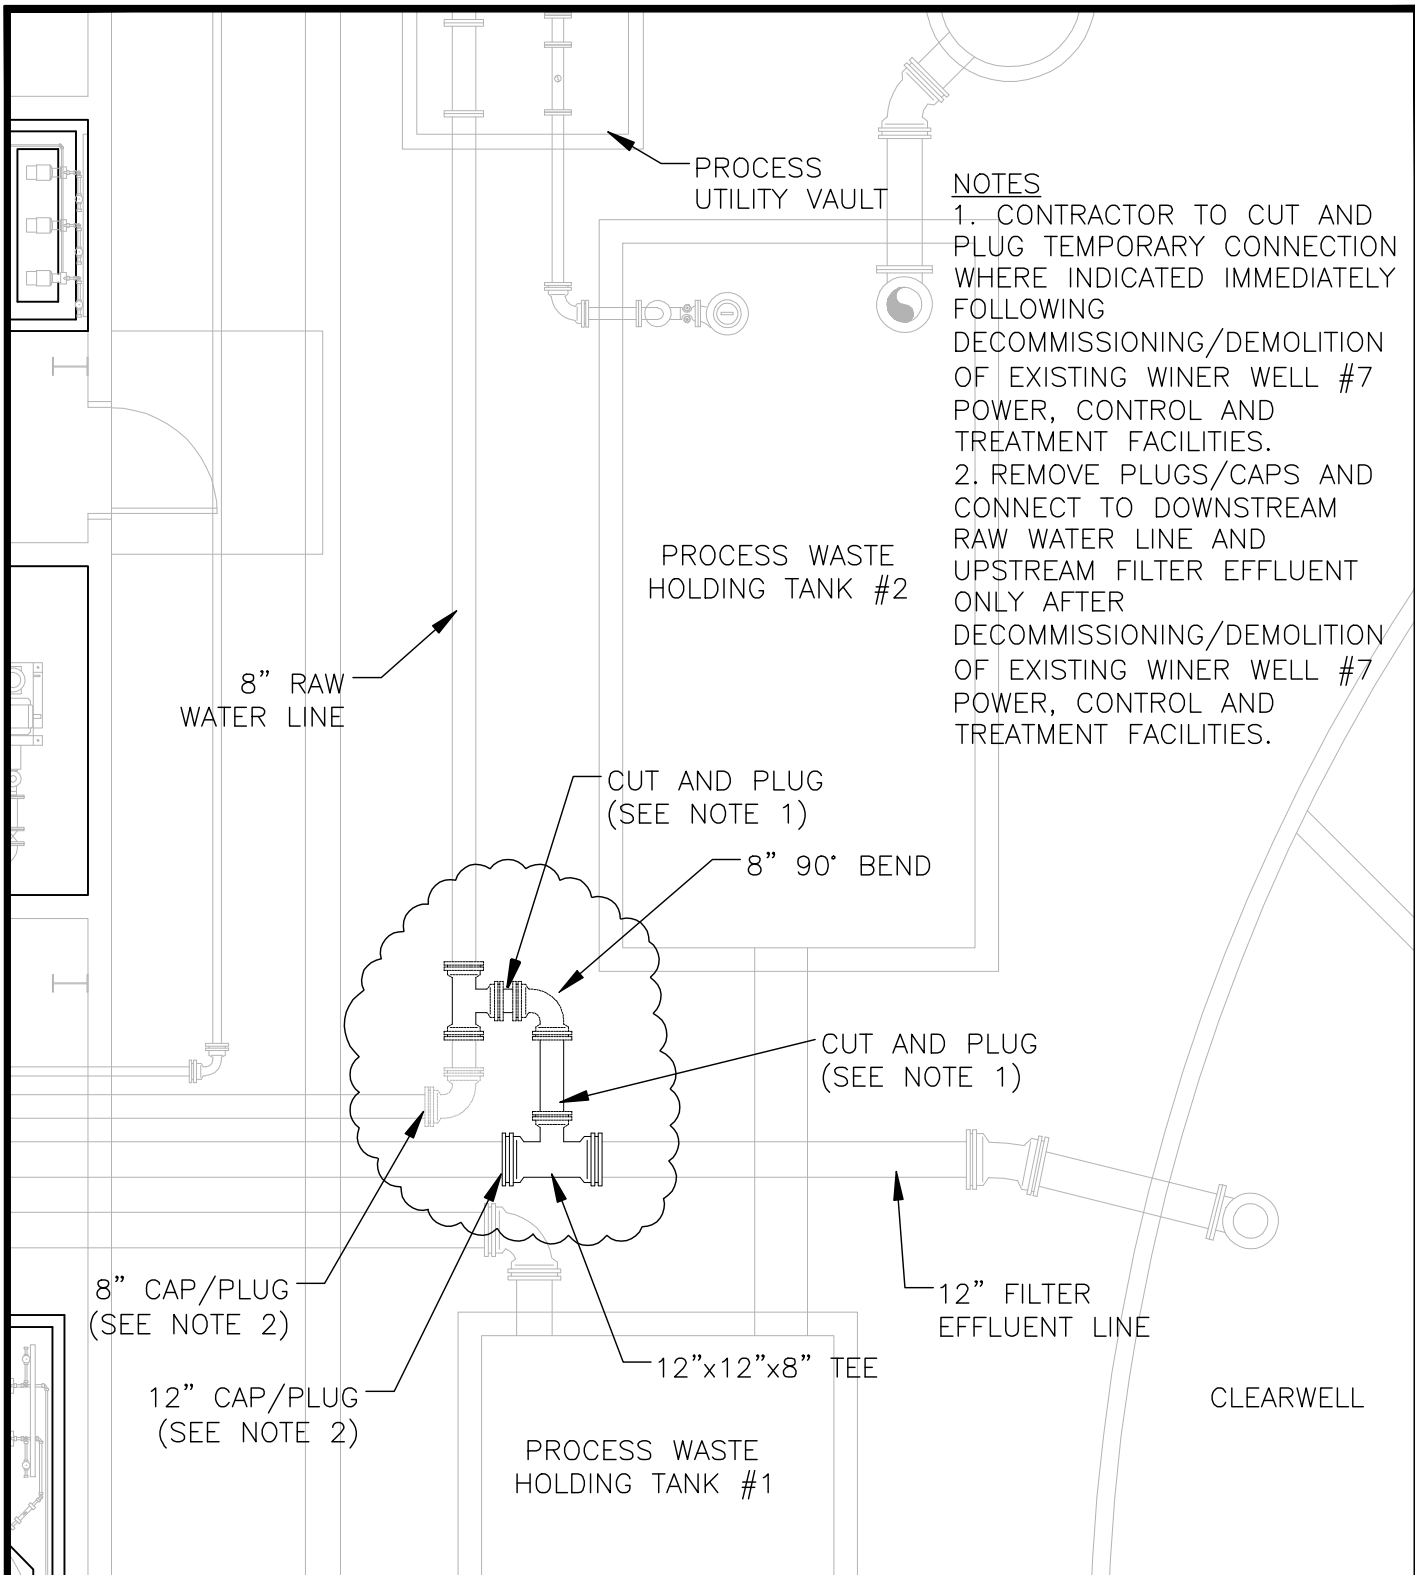

**NOTES**  
 1. CONTRACTOR TO CUT AND PLUG TEMPORARY CONNECTION WHERE INDICATED IMMEDIATELY FOLLOWING DECOMMISSIONING/DEMOLITION OF EXISTING WINER WELL #7 POWER, CONTROL AND TREATMENT FACILITIES.  
 2. REMOVE PLUGS/CAPS AND CONNECT TO DOWNSTREAM RAW WATER LINE AND UPSTREAM FILTER EFFLUENT ONLY AFTER DECOMMISSIONING/DEMOLITION OF EXISTING WINER WELL #7 POWER, CONTROL AND TREATMENT FACILITIES.

DATE: 03-05-10      JOB NUMBER :E08237

**ADDENDUM # 2  
 ATTACHMENT #2**

**CITY OF LAWRENCEVILLE  
 WATER SYSTEM IMPROVEMENTS  
 CONTRACT 2  
 WATER TREATMENT AND  
 WATER DEPARTMENT FACILITIES**



**Precision Planning, Inc.**  
 planners, engineers, architects & surveyors  
 P.O. Box 2210      PHONE:(770) 338-8000  
 400 Pike Boulevard      FAX: (770) 822-5990  
 Lawrenceville, GA 30246-2210